



Exhibit C - Floor Plan

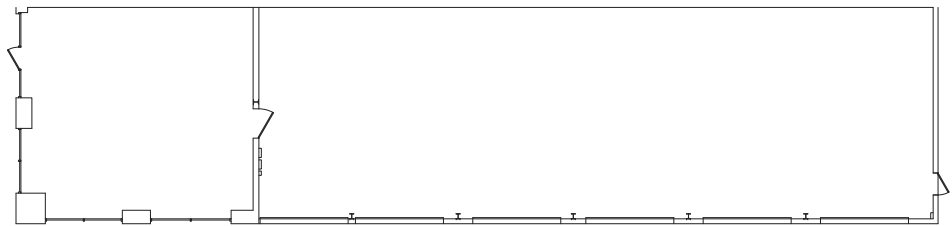

1 AS-BUILT FLOOR PLAN
Scale 1/8" = 1'-0"

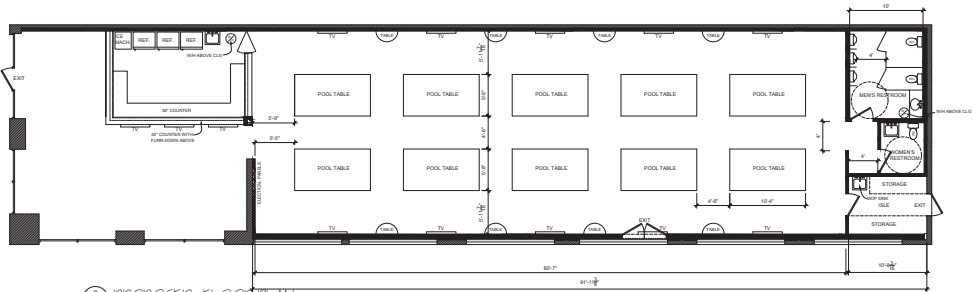

2 PROPOSED FLOOR PLAN
Scale 1/8" = 1'-0"
AREA OF RENOVATION : 3560 S.F.

Plan #
CC-110

THIS DRAWING AND ALL
CONTAINED THEREIN ARE
THE PROPERTY OF TREND
BUILDER. IT IS TO BE USED
FOR THE PROJECT AND NOT
BE LOANED, REPRODUCED,
COPIED, OR IN ANY MANNER
BEING USED FOR ANY OTHER
PROJECT OR PURPOSE. ANY
VIOLATION OF THIS NOTICE
WILL BE CONSIDERED A
BREACH OF CONTRACT AND
TREND BUILDER SHALL BE
ENTITLED TO SUCH REMEDY
AS IT MAY DEEM APPROPRIATE.

DATE: 8/31/18
SHEET: 1 OF 1

PROJECT:
INTERIOR RENOV.
FLOOR PLAN

CUSTOMER:
Bida Em
2625 W. PIONEER PKWY
GRAND PRAIRIE, TX

TREND
BUILDER

DATE:
8/31/18
SHEET:
1 OF 1

SU181004